


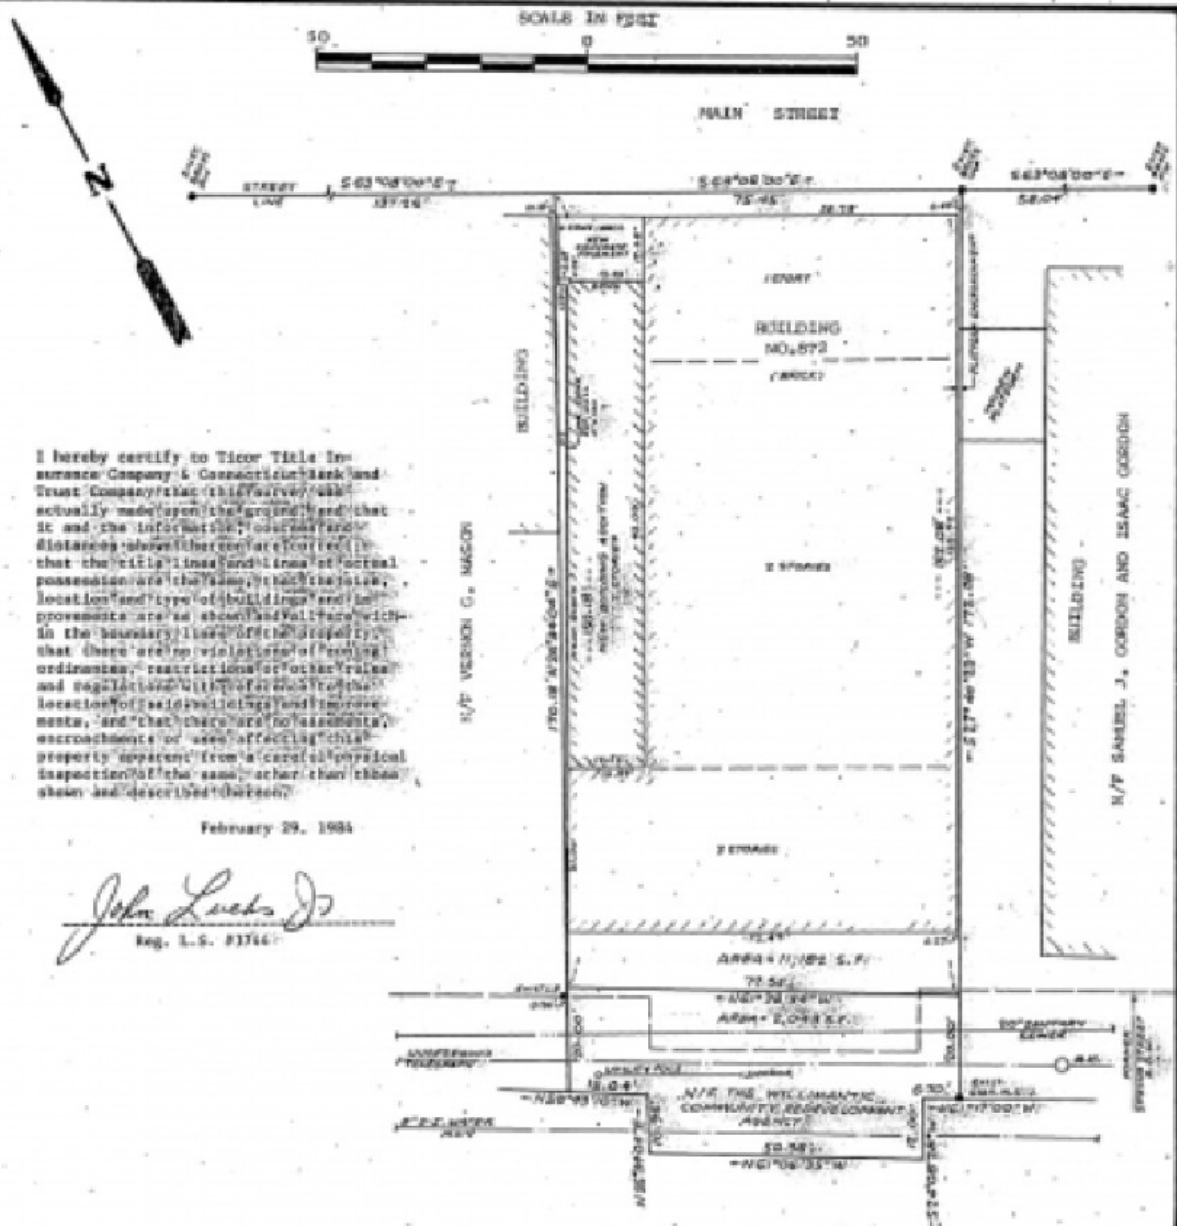

I hereby certify to Titor Title Insurance Company & Connecticut Bank and Trust Company that this survey was actually made upon the ground and that it and the information hereon are true and correct and that the title lines and lines of actual possession are the same, and that the size, location and type of buildings and improvements are as shown and that there is no violation of any local ordinance, restrictions or other rules and regulations of the town of Willimantic, and that there are no easements, encroachments or uses affecting this property apparent from a careful physical inspection of the same, other than those shown and described hereon.

February 29, 1984

John Luchs Jr.
Reg. L.S. #1744

N/Y NEW YORK, NEW HAVEN AND HARTFORD RAILROAD CO.

872'S E'ON IS MADE TO MAP FILED IN THE TOWN CLERK'S OFFICE IN WILLIMANTIC, CT, TITLED PROPERTY OF HERMAN C. MOSKOWITZ, MAIN ST., WILLIMANTIC, CONN., SCALE 1"=20', DATED JUNE 1969 BY THOMAS R. DANIELSON, L.S. AND DEED RECORDED IN VOLUME 353, PAGE 399 OF WILLIMANTIC LAND RECORDS.

UNDERGROUND UTILITIES AND FORMER SPRING STREET R.O.W. SHOWN PER MAPS BY OTHERS.

EXISTING UNDERGROUND STRUCTURES OR SERVICES ARE SHOWN IN AS NEAR THEIR CORRECT POSITION AS POSSIBLE. HOWEVER, ALL SUCH LOCATIONS ARE APPROXIMATE ONLY AND ALL SUCH STRUCTURES OR SERVICES MAY NOT BE SHOWN.

I hereby certify that this map and survey were prepared in accordance with the standards of a Class A-2 Survey as defined in the Code of Practice for Standards of Accuracy of Surveys and Maps, adopted December 18, 1973 as amended by the Connecticut Association of Land Surveyors, Inc.

John Luchs Jr.

REV. 2-28-84 : UPDATED AND CERTIFICATION ADDED.

MAP
PREPARED FOR
B & B REALTY
872 MAIN STREET
WILLIMANTIC, CT.

LUCHS & BECKERMAN CIVIL ENGINEERS, PLANNERS, LAND SURVEYORS GLASTONBURY, CONN.	
B - 83 - 35	
SCALE 1"=20'	DATE 3-2-83

check 3/10/83 at 10:00 AM

DRAWING NUMBER
11118 Map 12

11118 Map 12