


4W(A)
9,000 sqft

18,000 Total

4E(B)
9,000 sqft

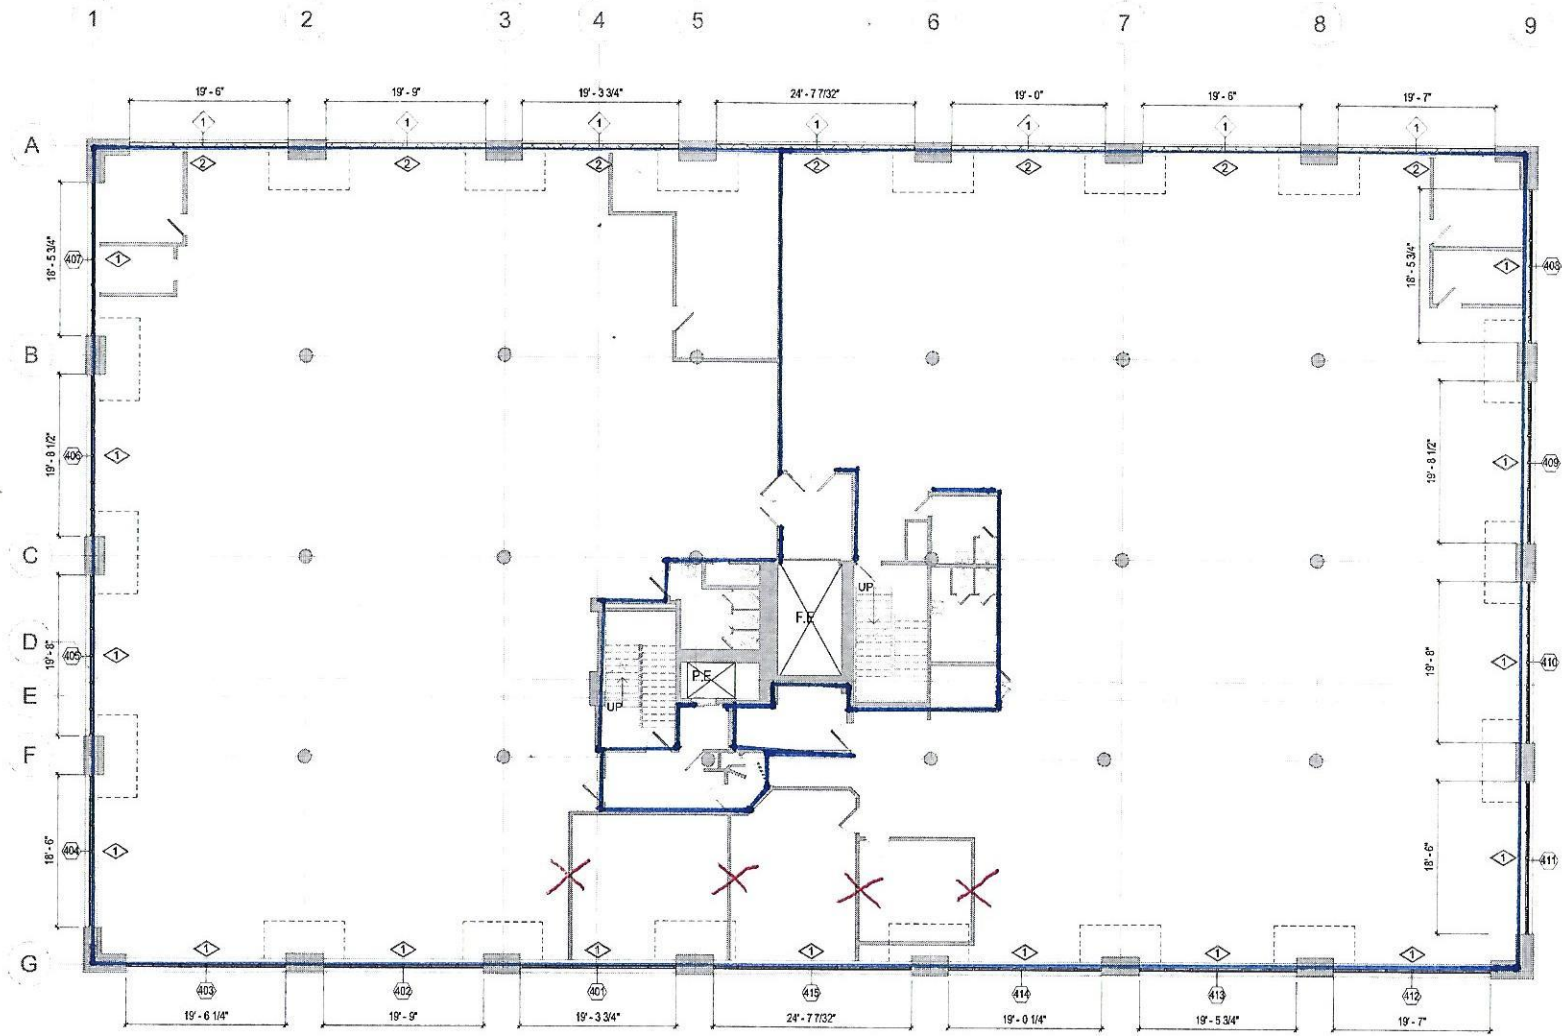

39th St.

43RD AVE

FOURTH FLOOR PLAN