


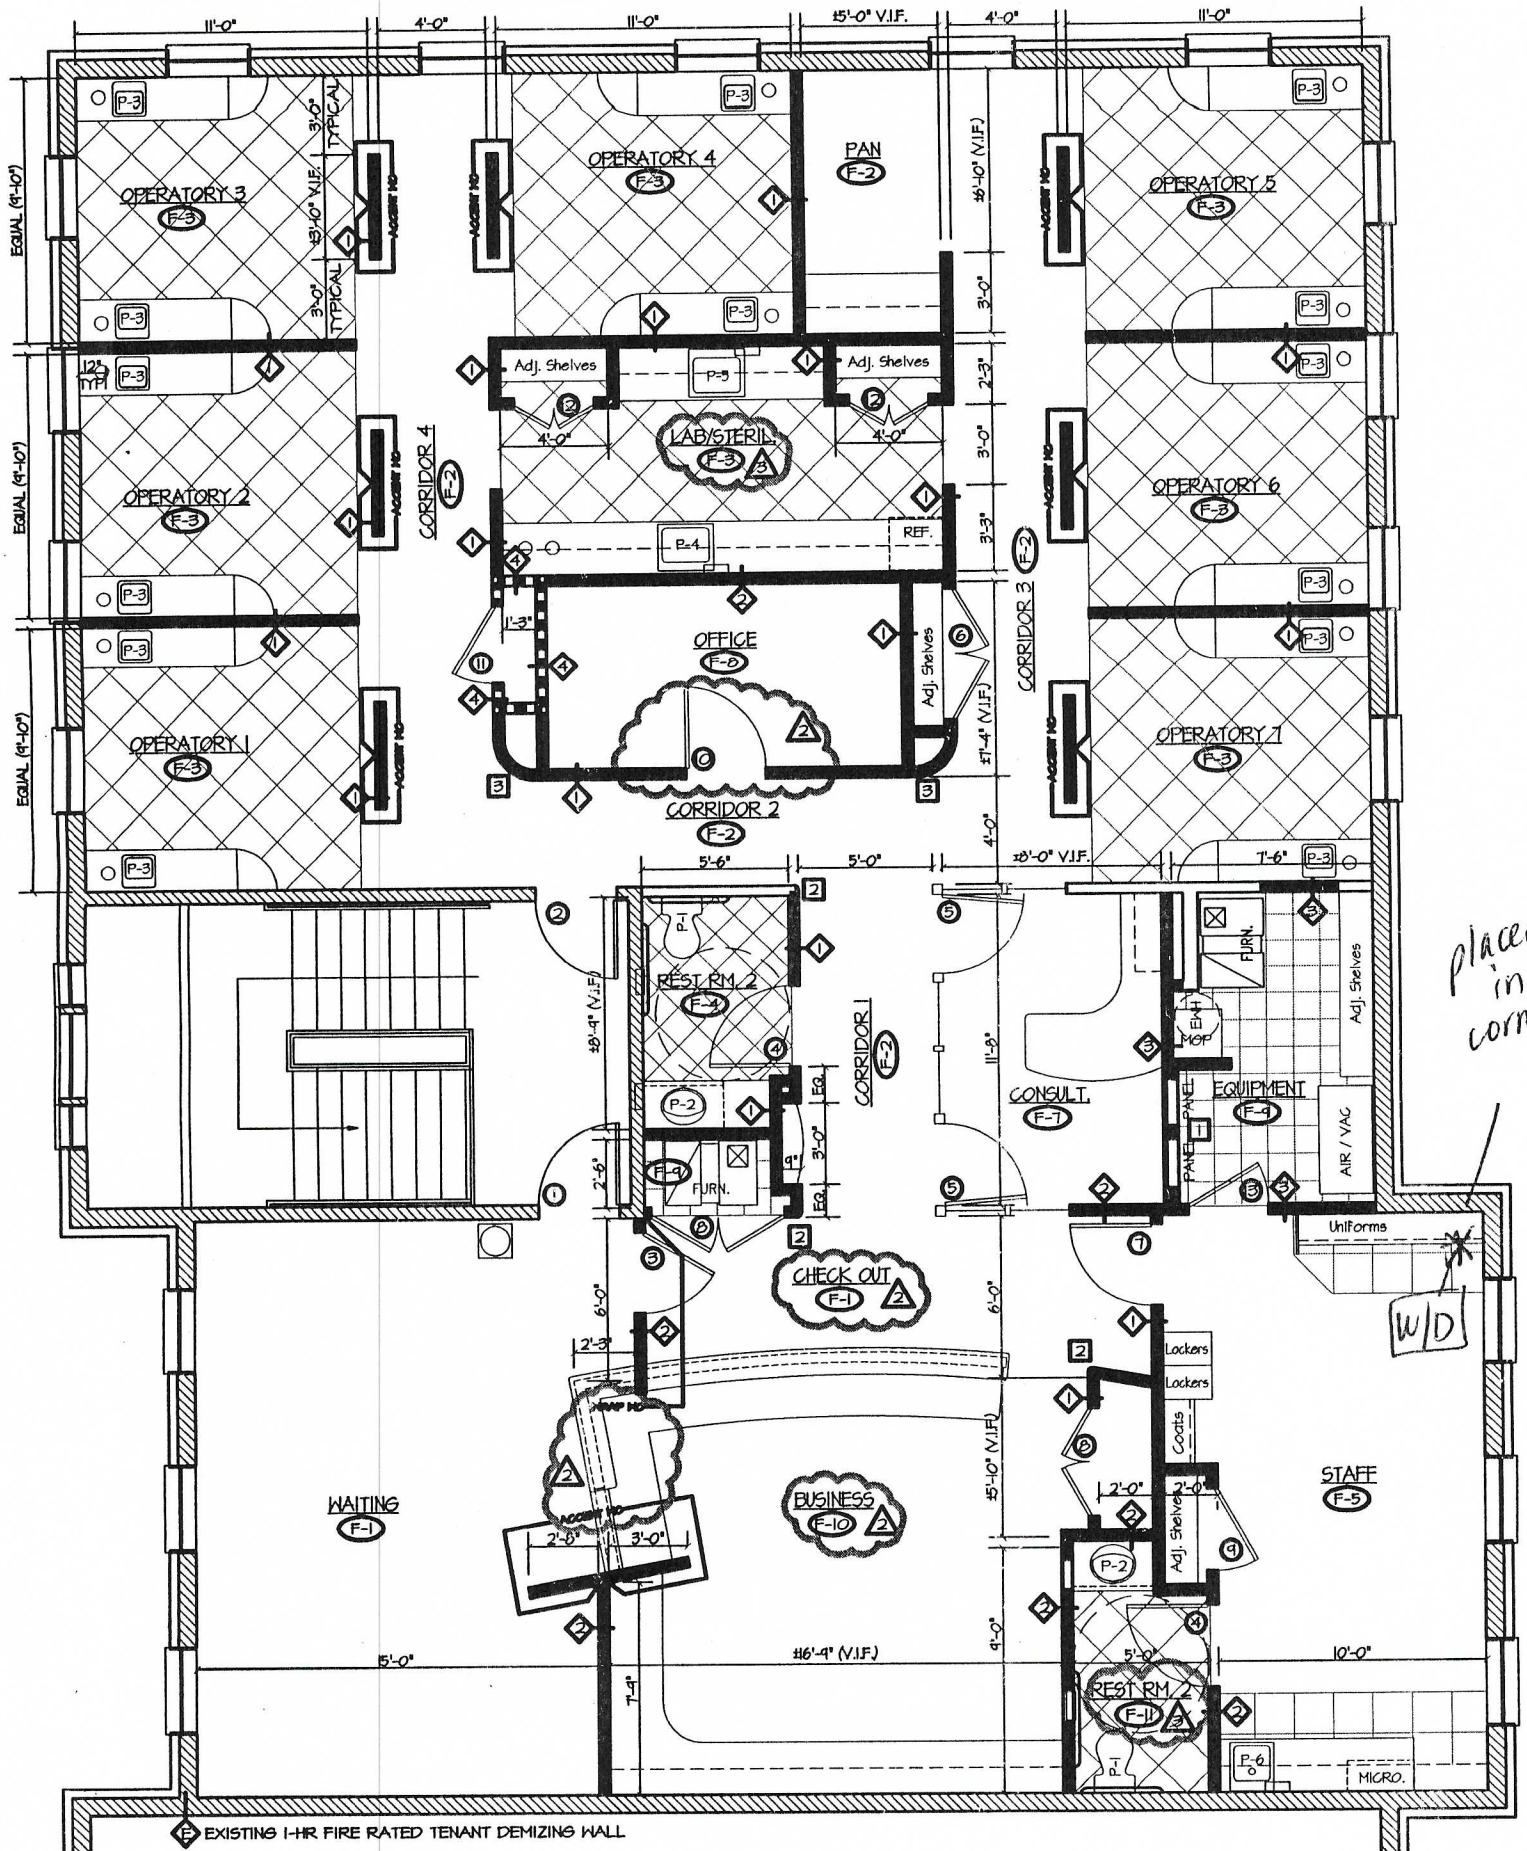

JOSE ANUN DD5
6134 REDWOOD SQ #202, CENTREVILLE