


COLN AVENUE) IN KRENN AND DATO'S POLOGROUND ADDITION TO NORTH
 EWER IN THE SOUTH WEST 1/4 OF SECTION 1, TOWNSHIP 40 NORTH, RANGE
 EAST OF THE THIRD PRINCIPAL MERIDIAN, IN COOK COUNTY, ILLINOIS

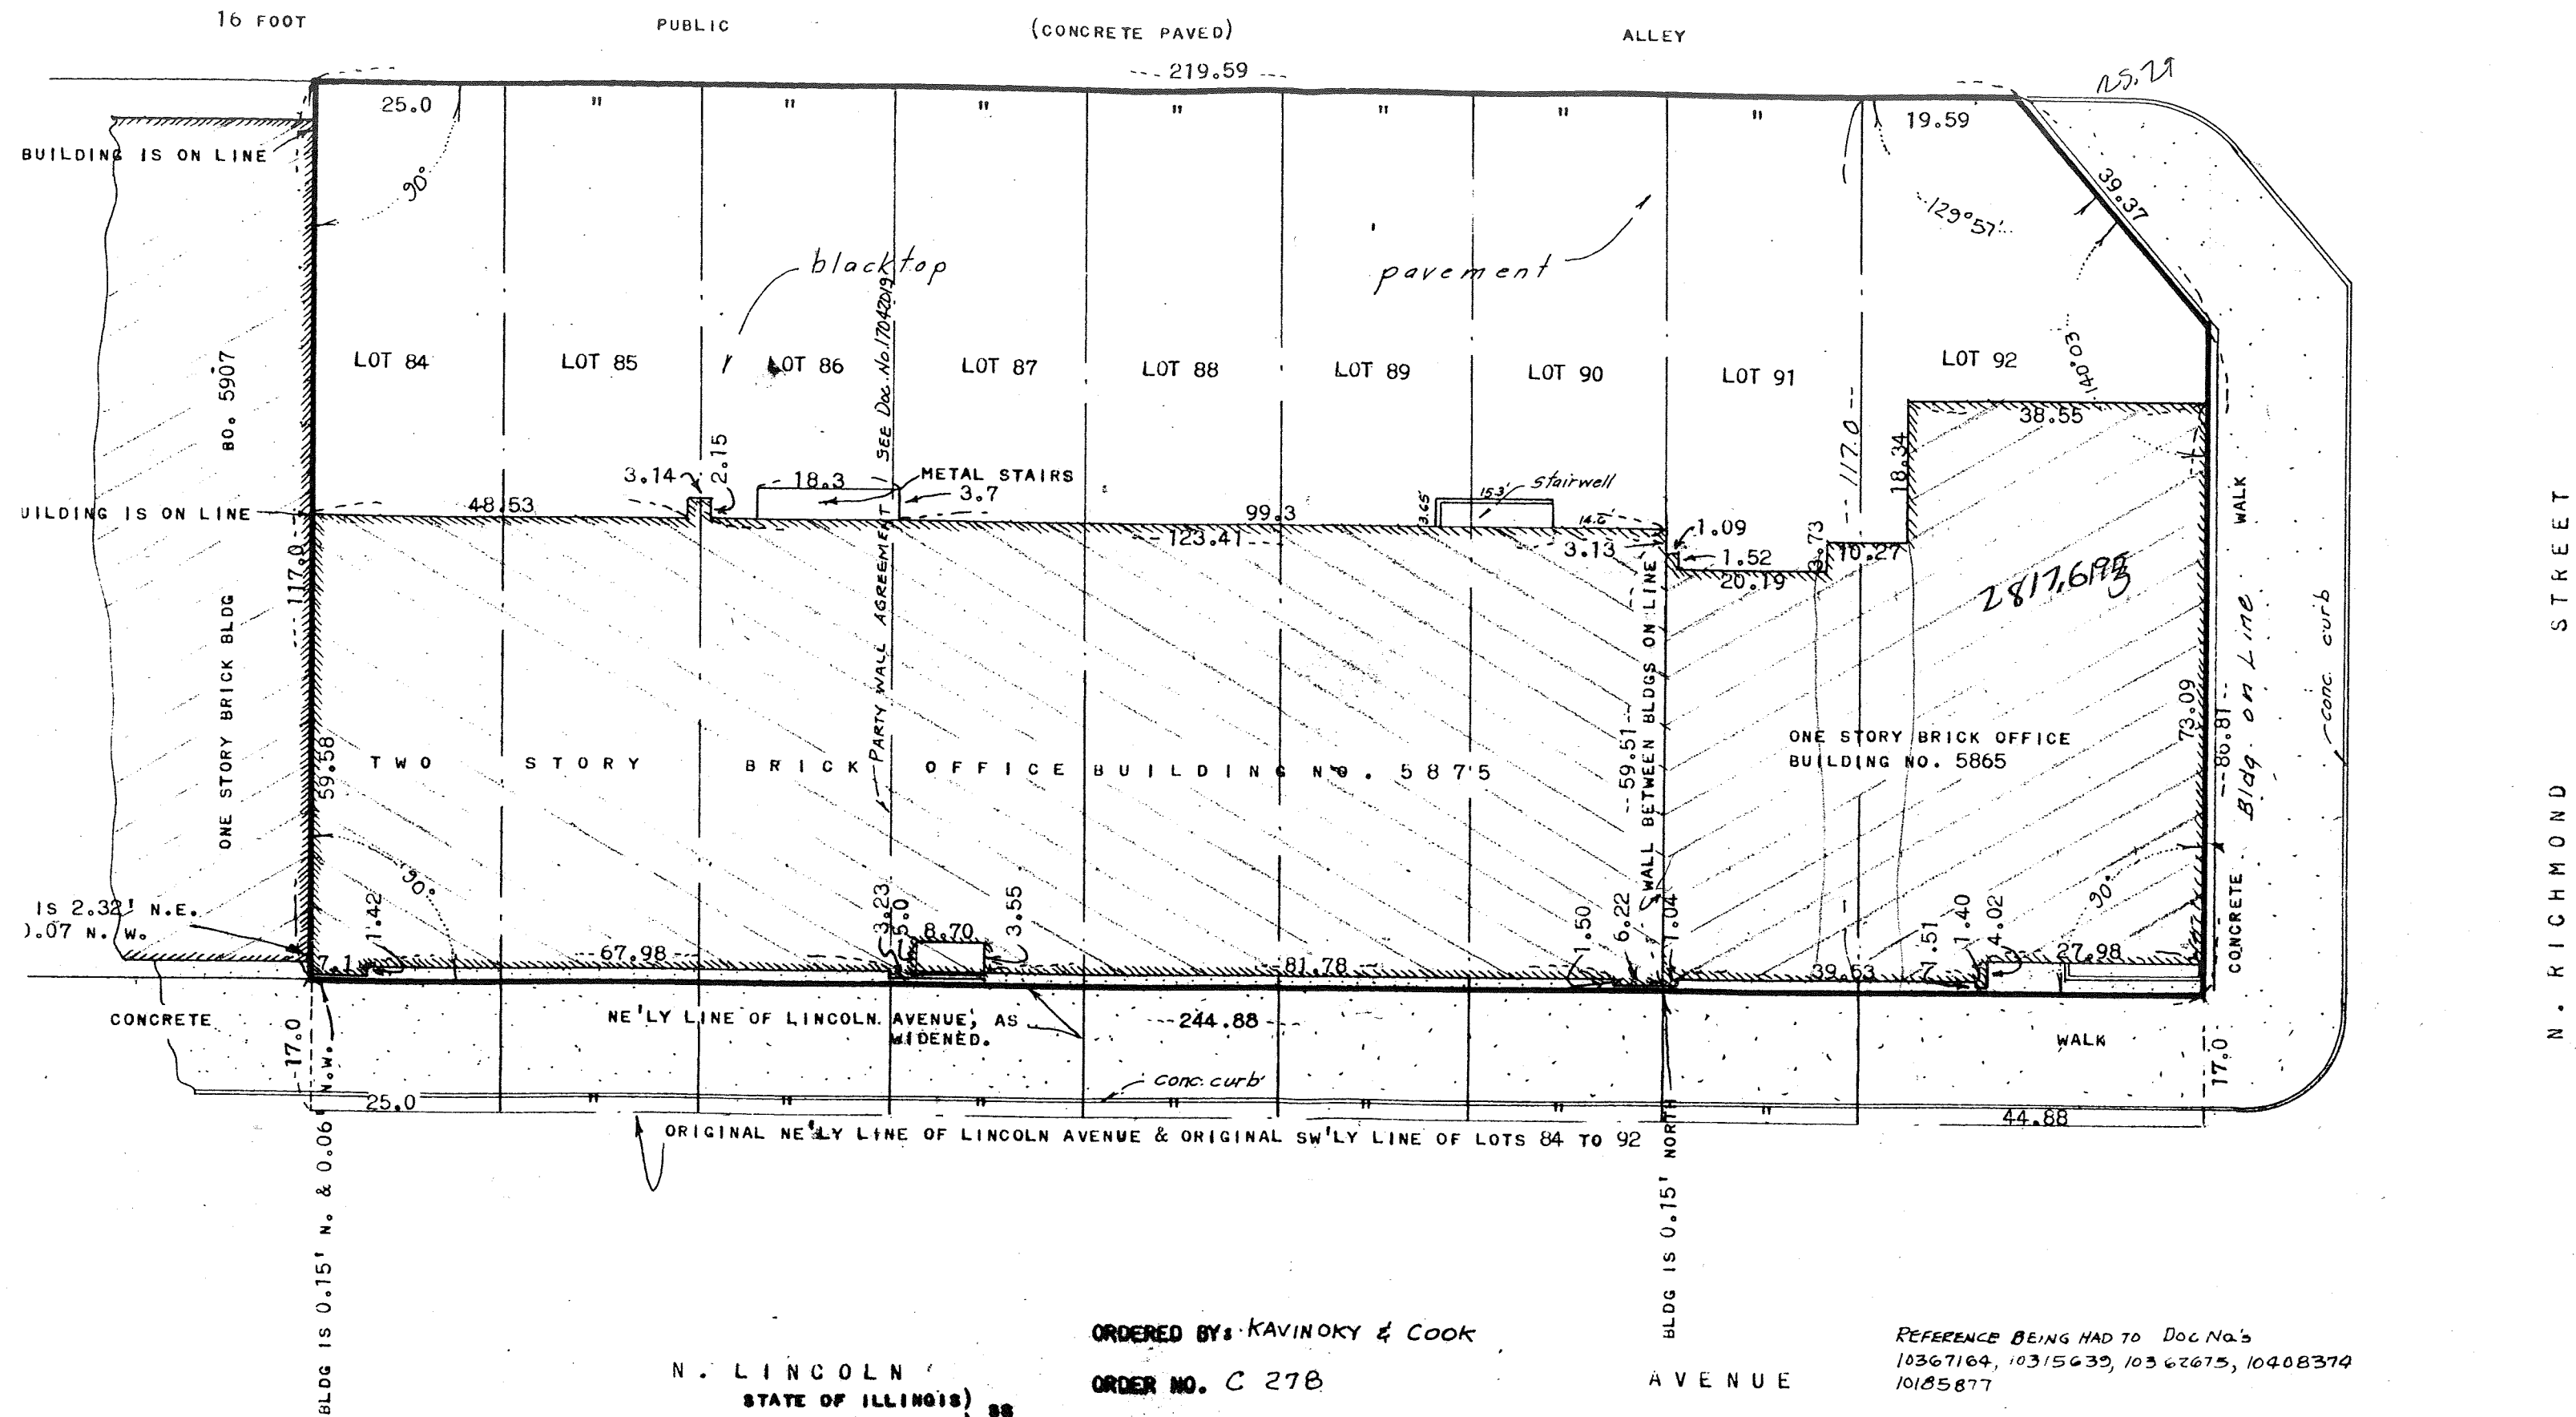

ORDERED BY: KAVINOKY & COOK

ORDER NO. C 278

REFERENCE BEING HAD TO Doc No's
 10367164, 10315639, 10362675, 10408374
 10185877

N. LINCOLN
 STATE OF ILLINOIS)
 COUNTY OF COOK)

TO: FIRSTMARK CREDIT CORPORATION
 CHICAGO TITLE INSURANCE COMPANY
 AMERICAN NATIONAL BANK AND TRUST COMPANY (TRUST NO. 42892)
 DIRECTOR GENERAL

ED BY WARADY AND DAVIS