
Suite D Floorplan

3441 Lawrenceville Suwanee Road

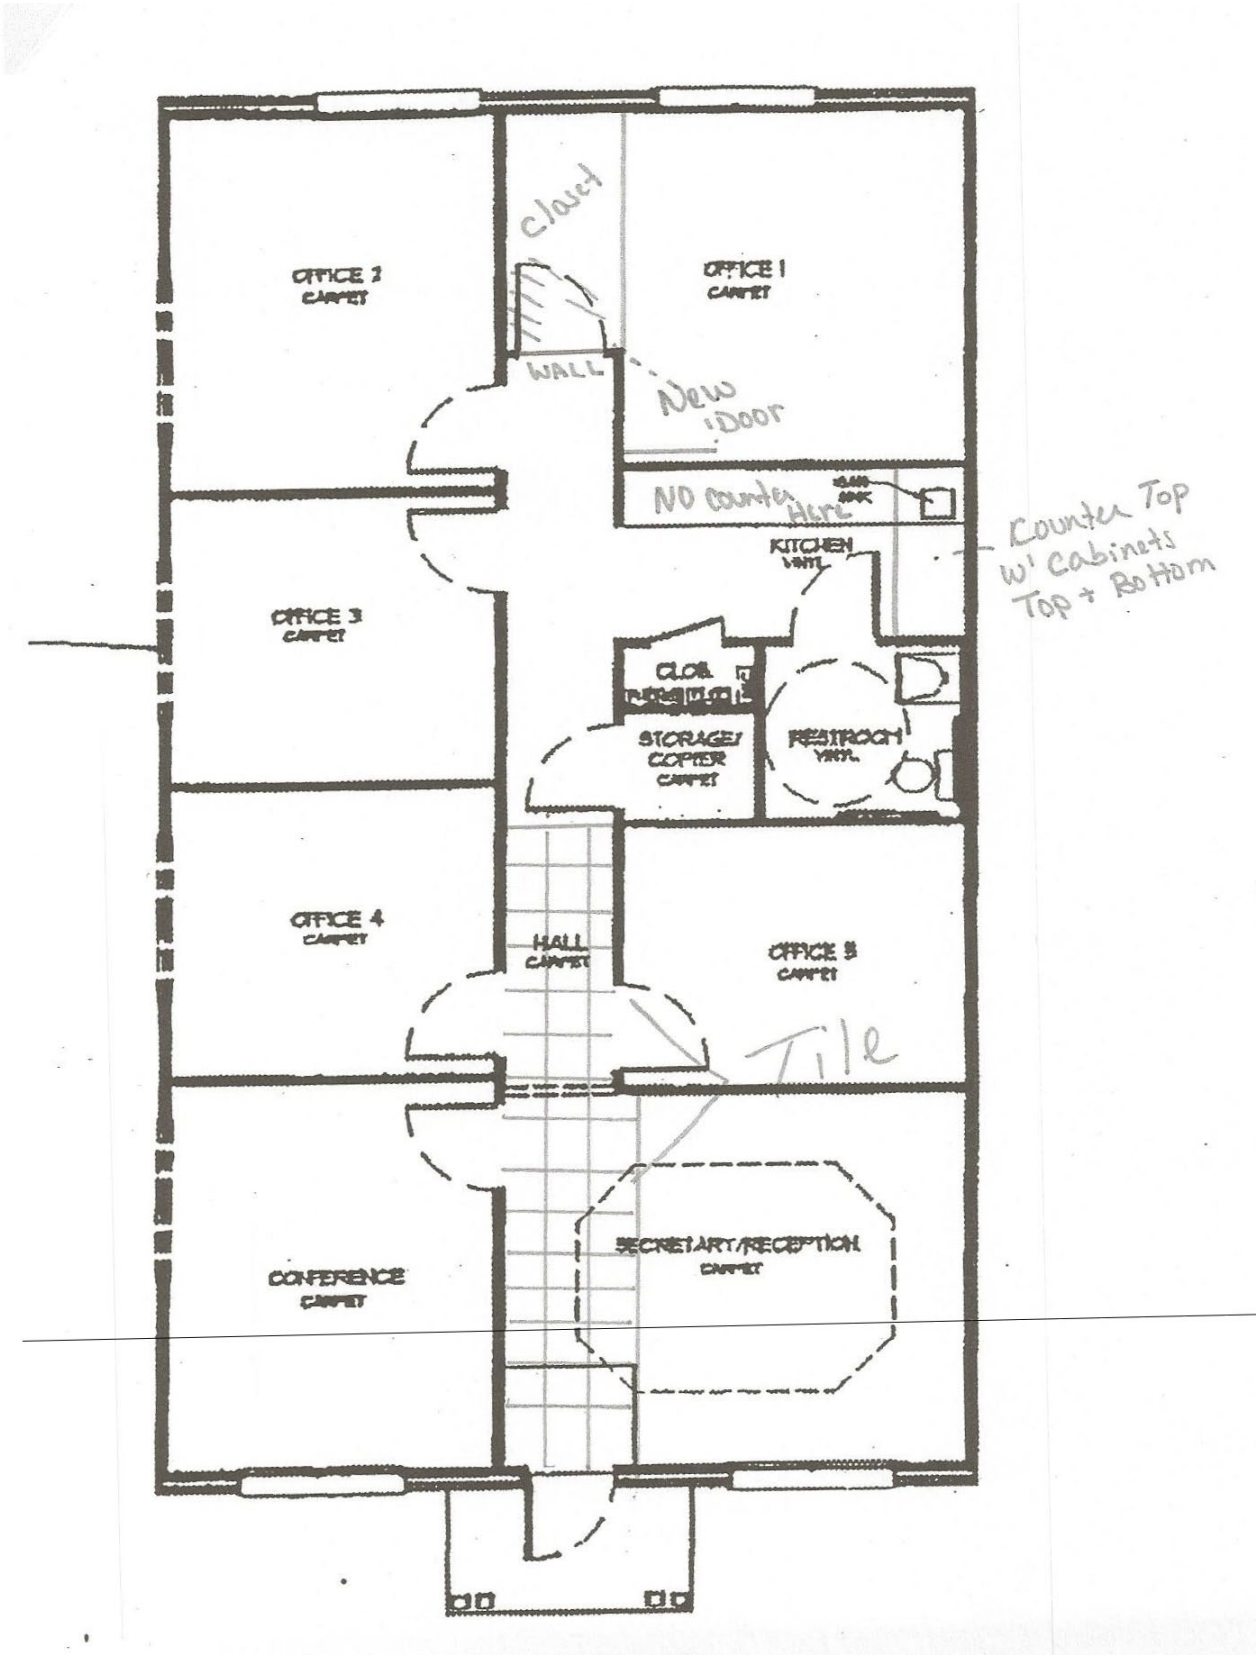

Brad Roper
Vice President
D +1 404 865 3663
C +1 404 944 3875
brad.roper@avisonyoung.com

Young – Atlanta LLC | 1230 Peachtree St NE, #3400| Atlanta, GA 30309

© 2025. Avison Young - Atlanta. Information contained herein was obtained from sources deemed reliable and, while thought to be correct, have not been verified.
Avison Young - Gainesville does not guarantee the accuracy or completeness of the information presented, nor assumes any responsibility or liability for any errors or omissions therein.