

CENTRAL EASTSIDE

3611 SE 20th Avenue
Portland, OR 97202

LEASING CONTACTS

J.T. Sand

Vice President

+1 503 542 5896

jt.sand@colliers.com

Jamison Shields

Associate

+1 503 265 5065

jamison.shields@colliers.com



Colliers

BUILDING HIGHLIGHTS



Modern construction



Flexible lease terms



Convenient
access to MAX
Orange Line



Parking
available



On-site landlord/
management




Located at
the Lafayette
Pedestrian Bridge




Lafayette Pedestrian Bridge

3rd Floor 5,000 RSF

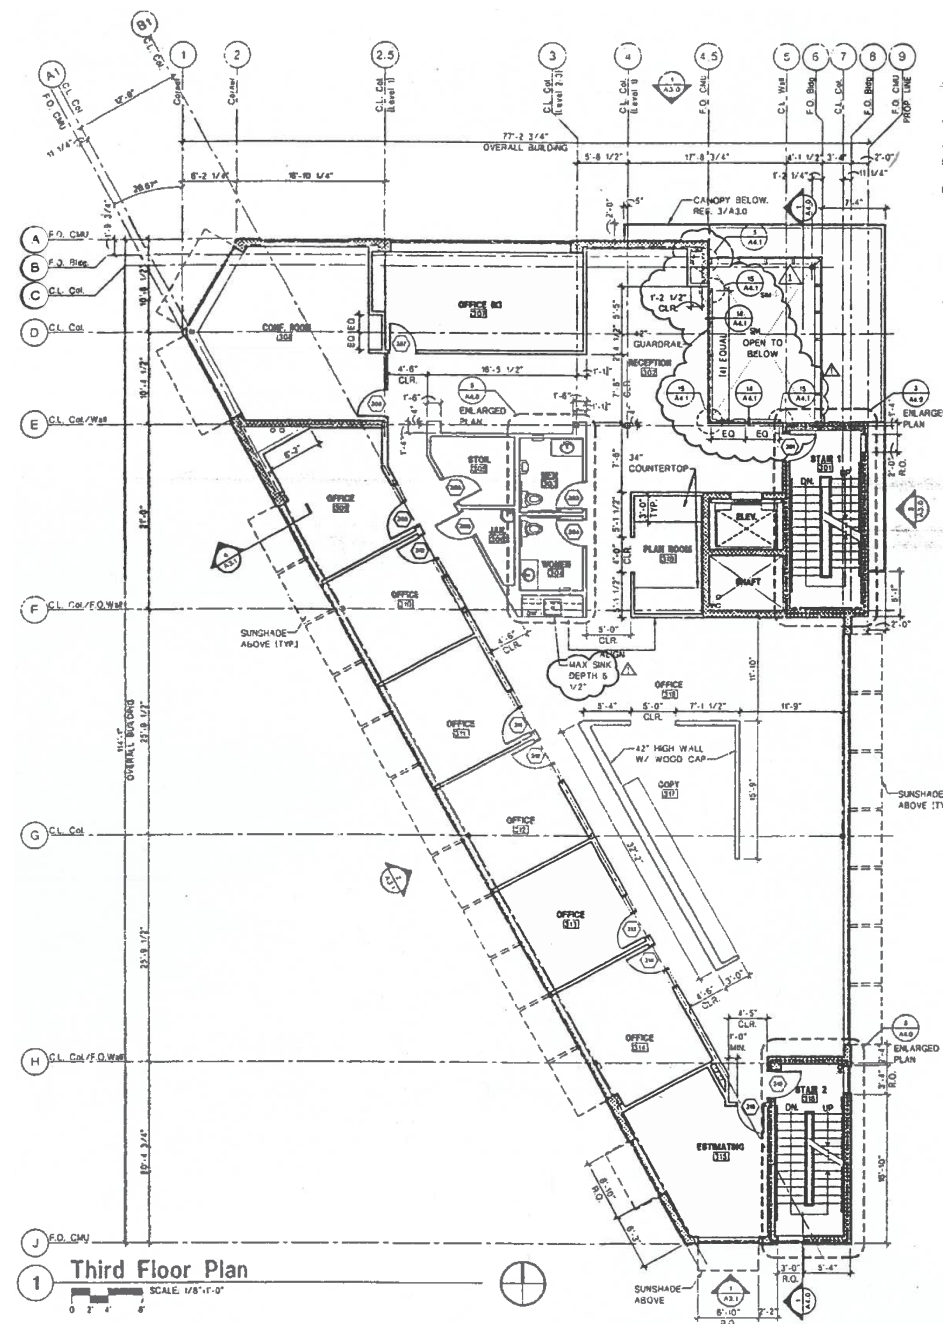

LOCATED NEAR THE HEART OF SOUTHEAST PORTLAND

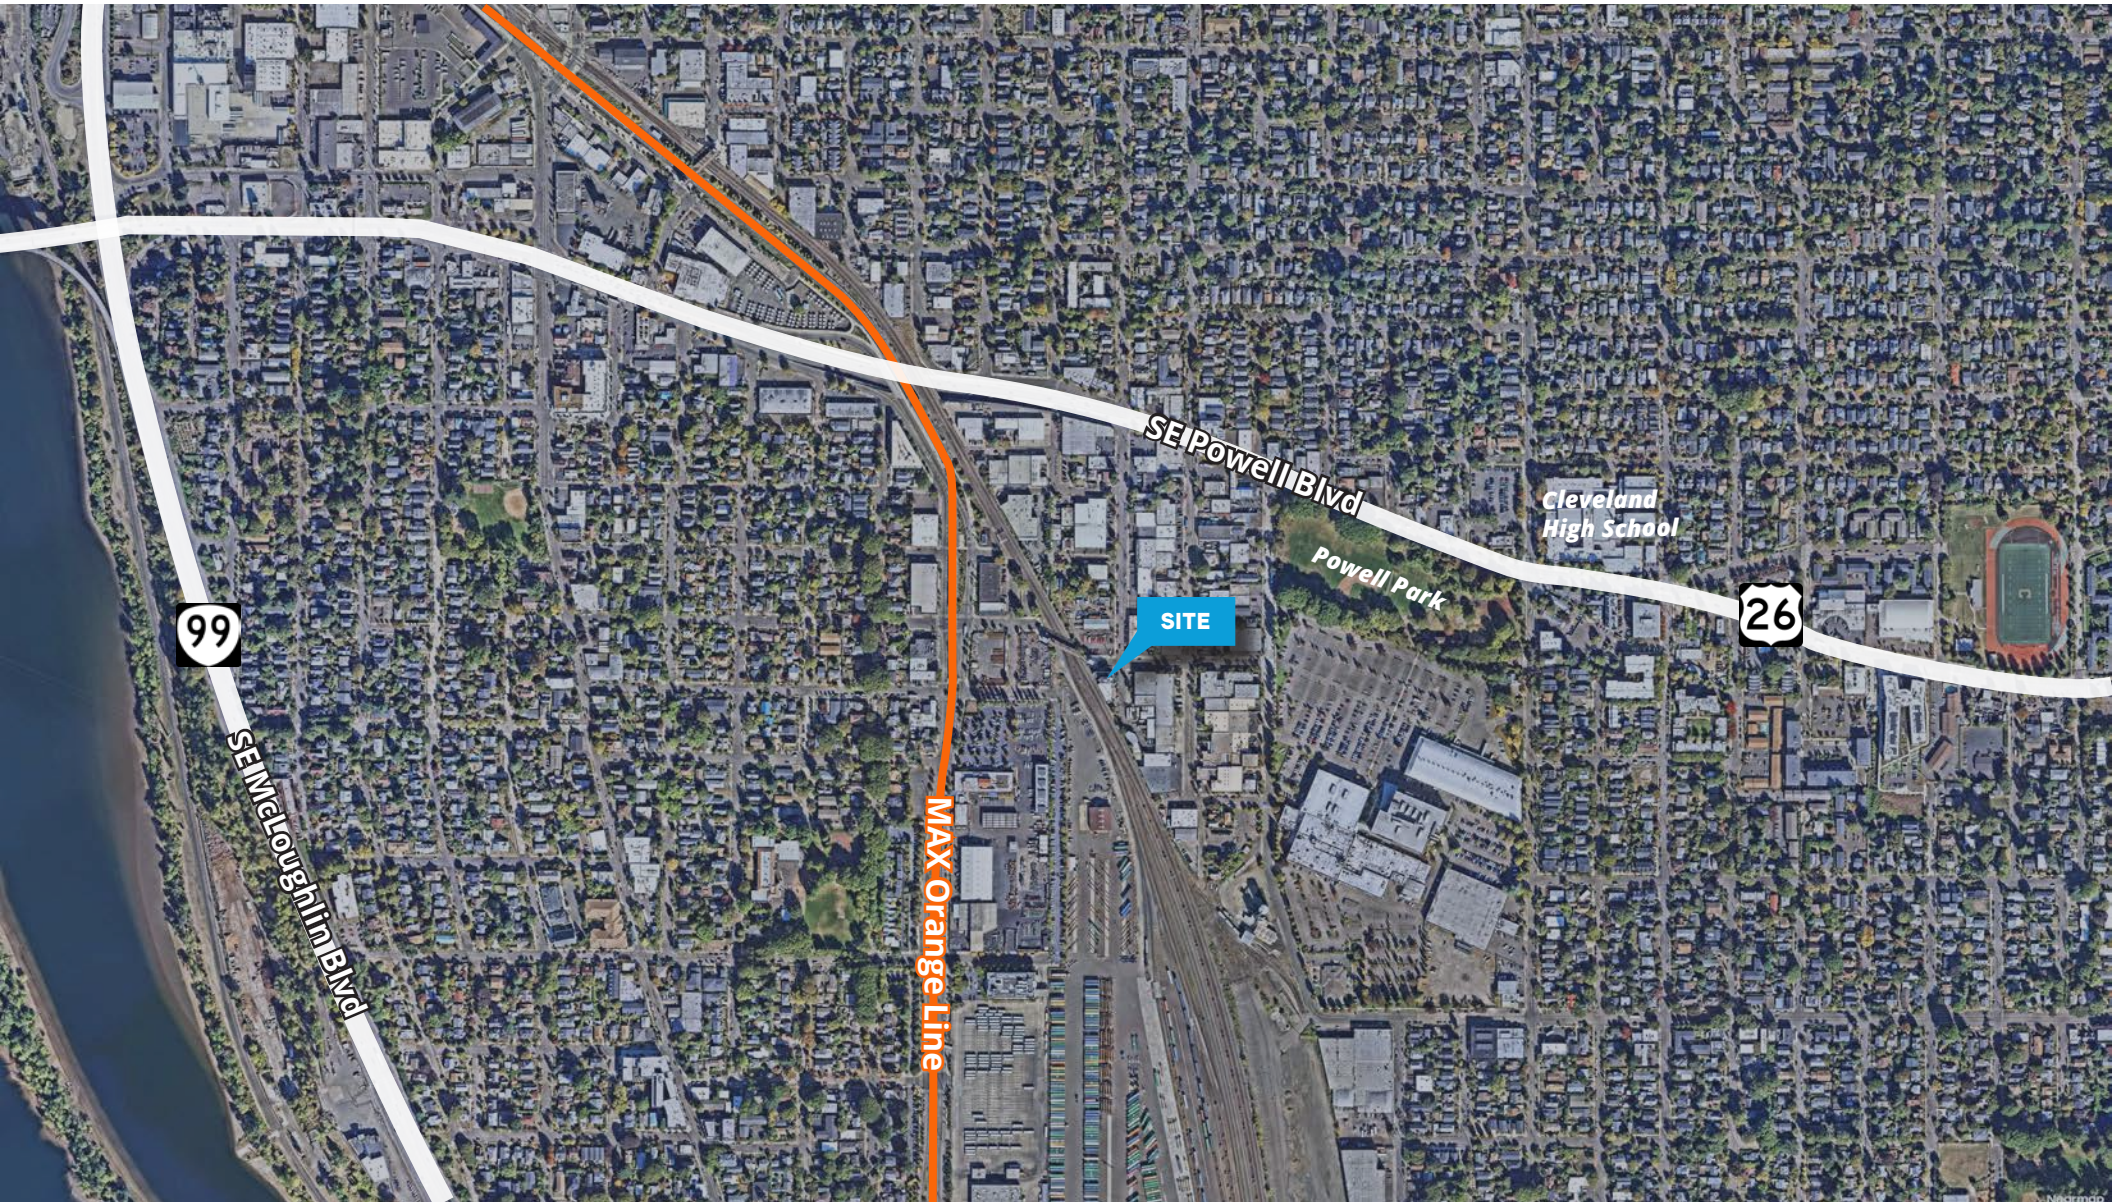

80

BIKE SCORE



78

WALK SCORE



55

TRANSIT SCORE

CENTRAL EASTSIDE

3611 SE 20th Avenue
Portland, OR 97202



LEASING CONTACTS

J.T. Sand

Vice President

+1 503 542 5896

jt.sand@colliers.com

Jamison Shields

Associate

+1 503 265 5065

jamison.shields@colliers.com



This document/email has been prepared by Colliers for advertising and general information only. Colliers makes no guarantees, representations or warranties of any kind, expressed or implied, regarding the information including, but not limited to, warranties of content, accuracy and reliability. Any interested party should undertake their own inquiries as to the accuracy of the information. Colliers excludes unequivocally all inferred or implied terms, conditions and warranties arising out of this document and excludes all liability for loss and damages arising there from. This publication is the copyrighted property of Colliers and / or its licensor(s). © 2024. All rights reserved. This communication is not intended to cause or induce breach of an existing listing agreement.