HOLLINS FERRY THREE

3337-3339 HOLLINS FERRY ROADBALTIMORE, MD 21227

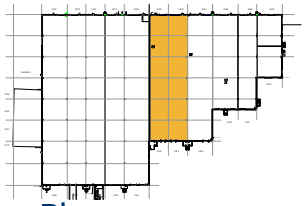

Key Plan

TOTAL SF AVAILABLE -12,000 SF

OFFICE - 0,000 SF

WAREHOUSE - 12,000 SF

Click to access **CADD file**

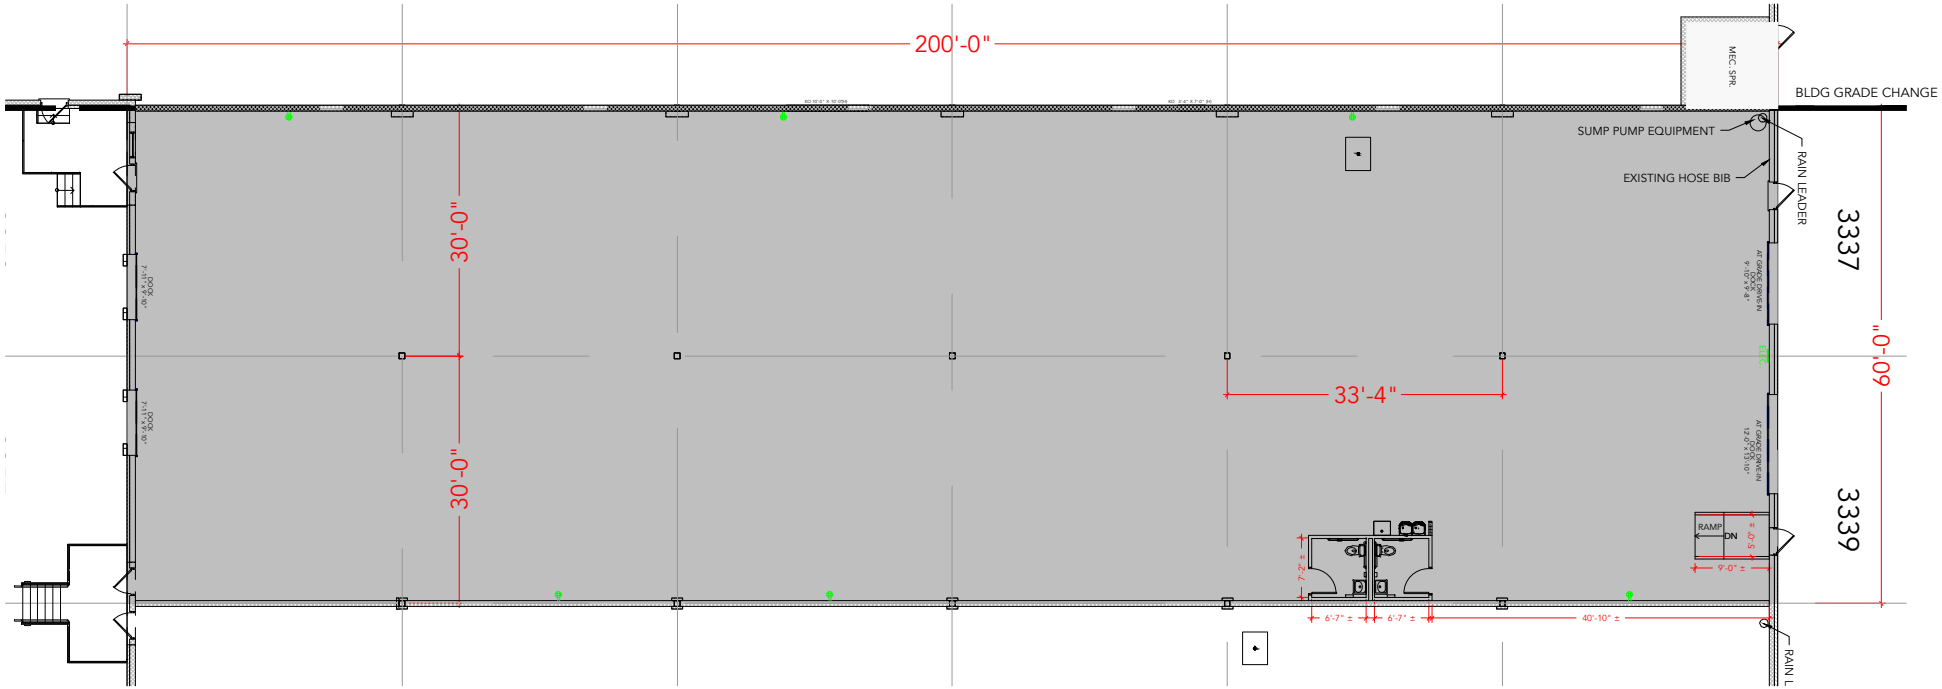

Floor Plan

PLAN NOT TO SCALE - THIS IS NOT A CONSTRUCTION DOCUMENT

DRAWING #: 017-3337-39 ASBUILT DATE: 12/24/2025